


Lakeside Office Center

SUITE 320 -AS BUILT - 1,788 - R.S.F.

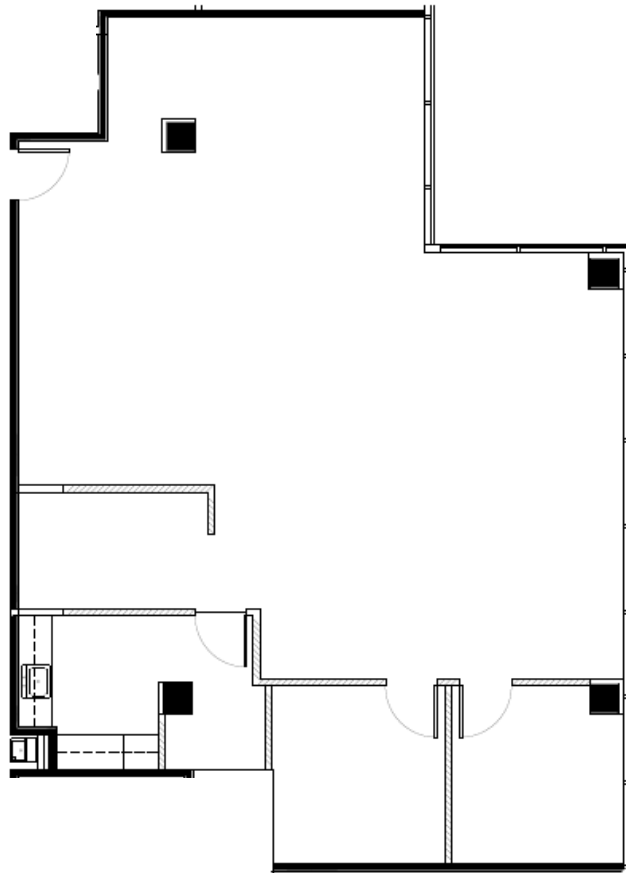

PROPERTY HIGHLIGHTS

- Five-story, Class "A" office building
- New Conference Center
- New exterior upgrades to entrance
- Newly renovated lobby and common areas
- Efficient floor plates
- Energy Star labeled
- New generator for life safety
- Fiber optics and Comcast available
- Loading dock
- 4:1,000 s.f. parking ratio
- On-site security and property management
- Beautiful lake views with lush tropical landscaping

FLOOR LEGEND



AVAILABLE 3/2019

WWW.LAKESIDEOFFICECENTER.COM